


REVISIONS

LOT 93/96 DIV. PER DEED CH. SH. 02-202
 LOT 93/95 DIV. PER DEED CH. SH. 06-123
 LOT 23-30 CONC'D Agr O.O. CH. SH. 18-158

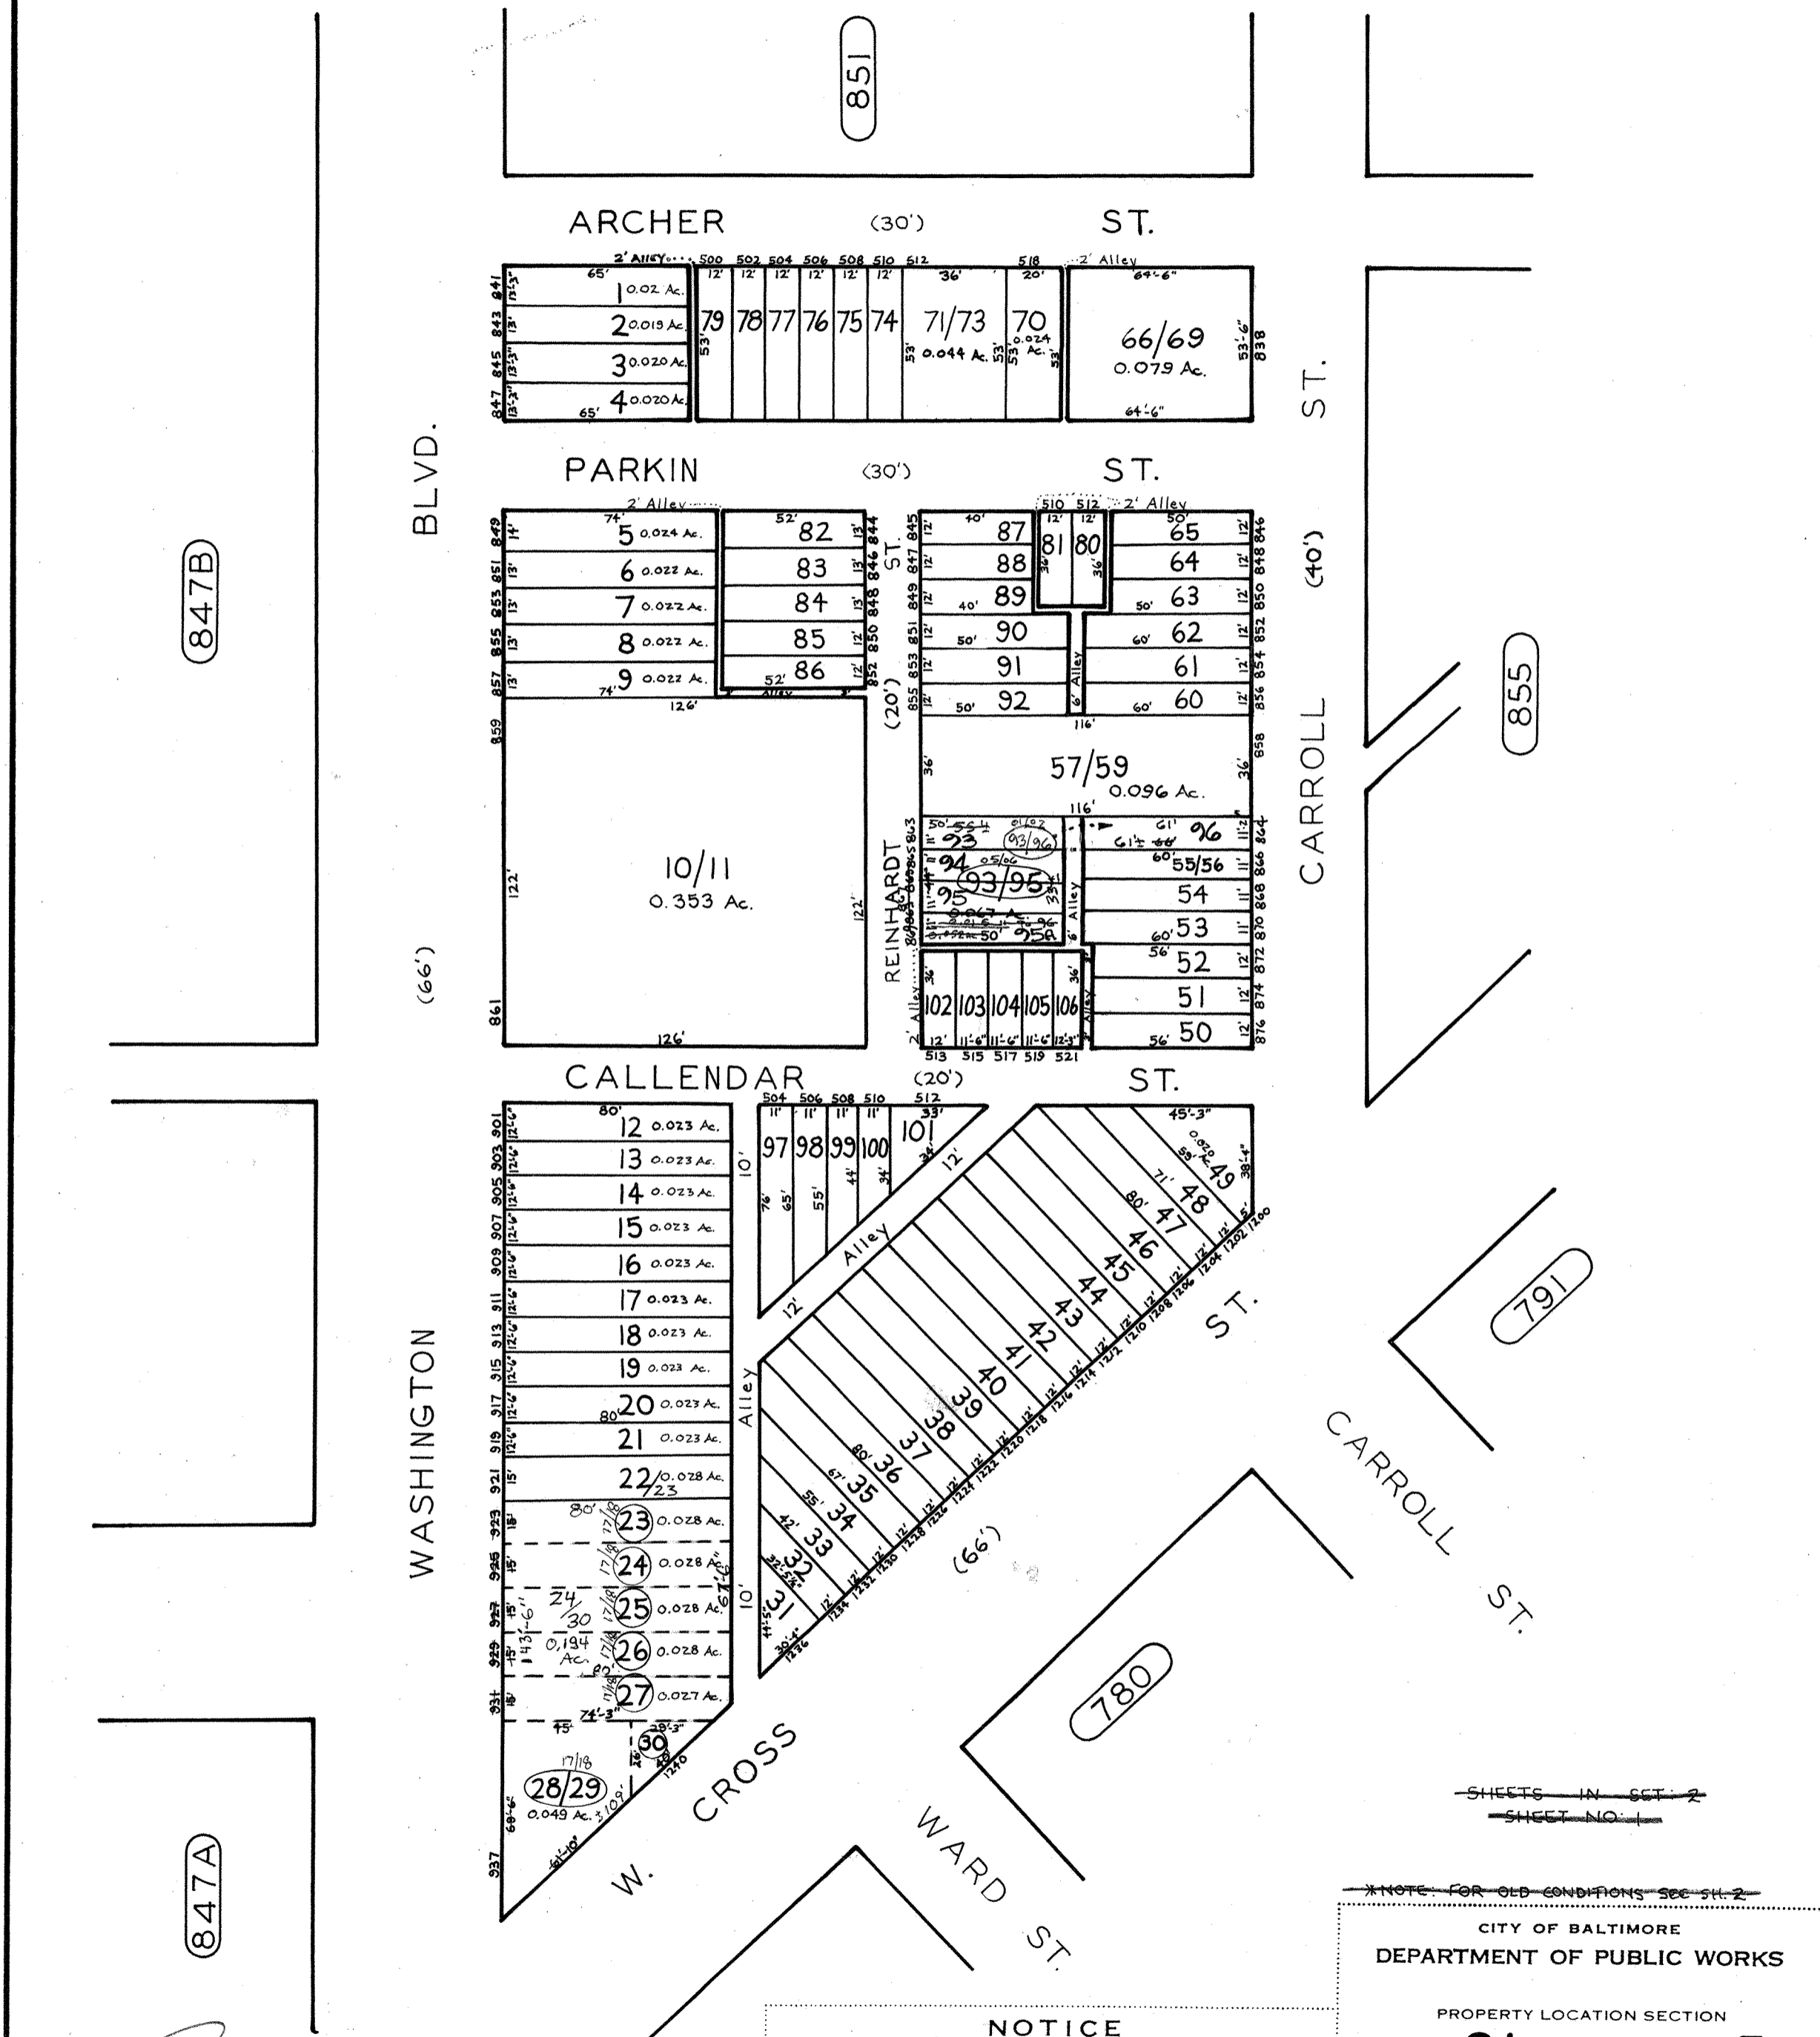

847B

847A

855

791

780

TRACED BY: *P.A.S.*
 LETTERED BY: *P.A.S.*
 CHECKED BY: _____

NOTICE
 THIS IS A REAL PROPERTY PLAT AS PROVIDED FOR UNDER ARTICLE 76(d) OF THE CITY CHARTER IT IS COMPILED FROM TITLE AND OTHER SOURCES AND IS NOT AN AUTHENTIC SURVEY.

~~SHEETS IN SET 2~~
~~SHEET NO. 1~~

~~NOTE FOR OLD CONDITIONS SEE SH. 2~~

CITY OF BALTIMORE
 DEPARTMENT OF PUBLIC WORKS

PROPERTY LOCATION SECTION
 WARD 21 SECTION 7
 BLOCK 850
 SCALE 1" = 50' DATE January 1997