


REVISION

LOTS 21 & 24 CONS'D. PER DEED C.S. 9451
 LOT 23 ADD'D. IN P.S.C. C.S. 9625-G

~~26-18-5/8~~
 6254-B

Musher & Co.

26-18-3
 6254

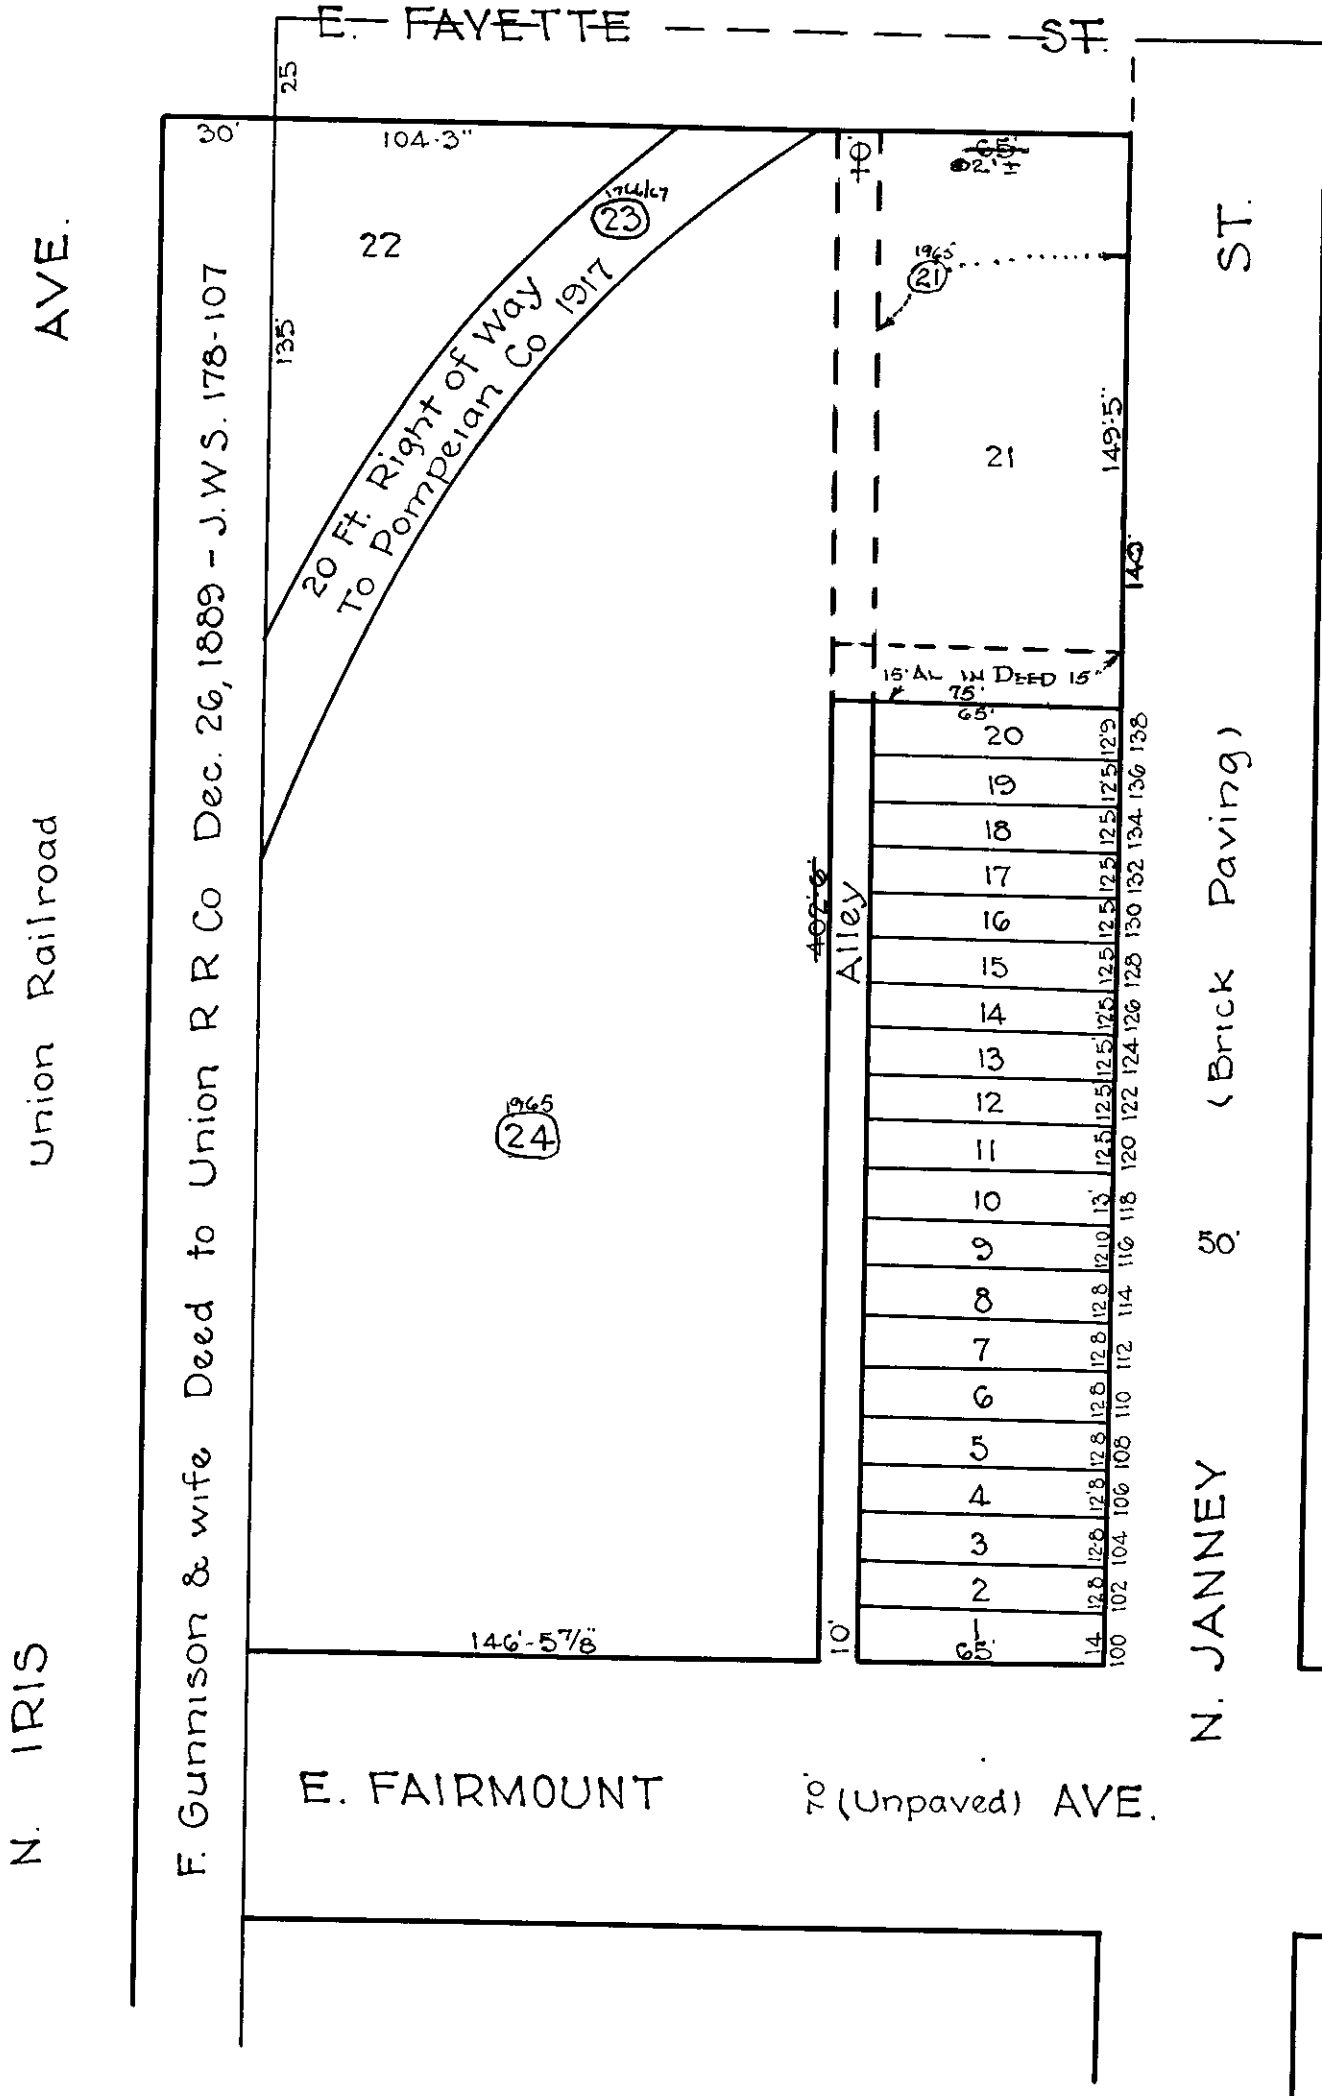

N. IRIS

F. Gunnison & wife Deed to Union R R Co Dec. 26, 1889 - J.W.S. 178-107

E. FAIRMOUNT 70 (Unpaved) AVE.

N. JANNEY 5' (Brick Paving)

6254-C
~~26-18-9~~

6263

~~26-18-11/18~~

NOTICE
 THIS IS A REAL PROPERTY PLAT AS PROVIDED FOR UNDER ARTICLE 76(d) OF THE CITY CHARTER IT IS COMPILED FROM TITLE AND OTHER SOURCES AND IS NOT AN AUTHENTIC SURVEY

NOTE ÷ BLOCK 26-18-10 FOR 1941.

~~6254~~

CITY OF BALTIMORE
 DEPARTMENT OF PUBLIC WORKS
 BUREAU OF PLANS & SURVEYS
 PROPERTY LOCATION DIVISION

WARD 26 SECTION 18
 BLOCK 6254-D

SCALE 1"=50'-0" DATE April 1931.

TRACED BY M.C. STUMPF
 LETTERED BY W.M.L.
 CHECKED BY